


EXISTING UNDERGROUND UTILITIES NOTE:
THE SIZE AND LOCATION, BOTH HORIZONTAL AND VERTICAL
OF THE UNDERGROUND UTILITIES SHOWN HEREON, HAVE BEEN OBTAINED BY A SEARCH OF AVAILABLE RECORDS. VERIFICATION BY FIELD OBSERVATION HAS BEEN CONDUCTED WHERE PRACTICAL. HOWEVER, POLARIS ENGINEERING & SURVEYING, INC. DOES NOT GUARANTEE THE COMPLETENESS NOR ACCURACY THEREOF.

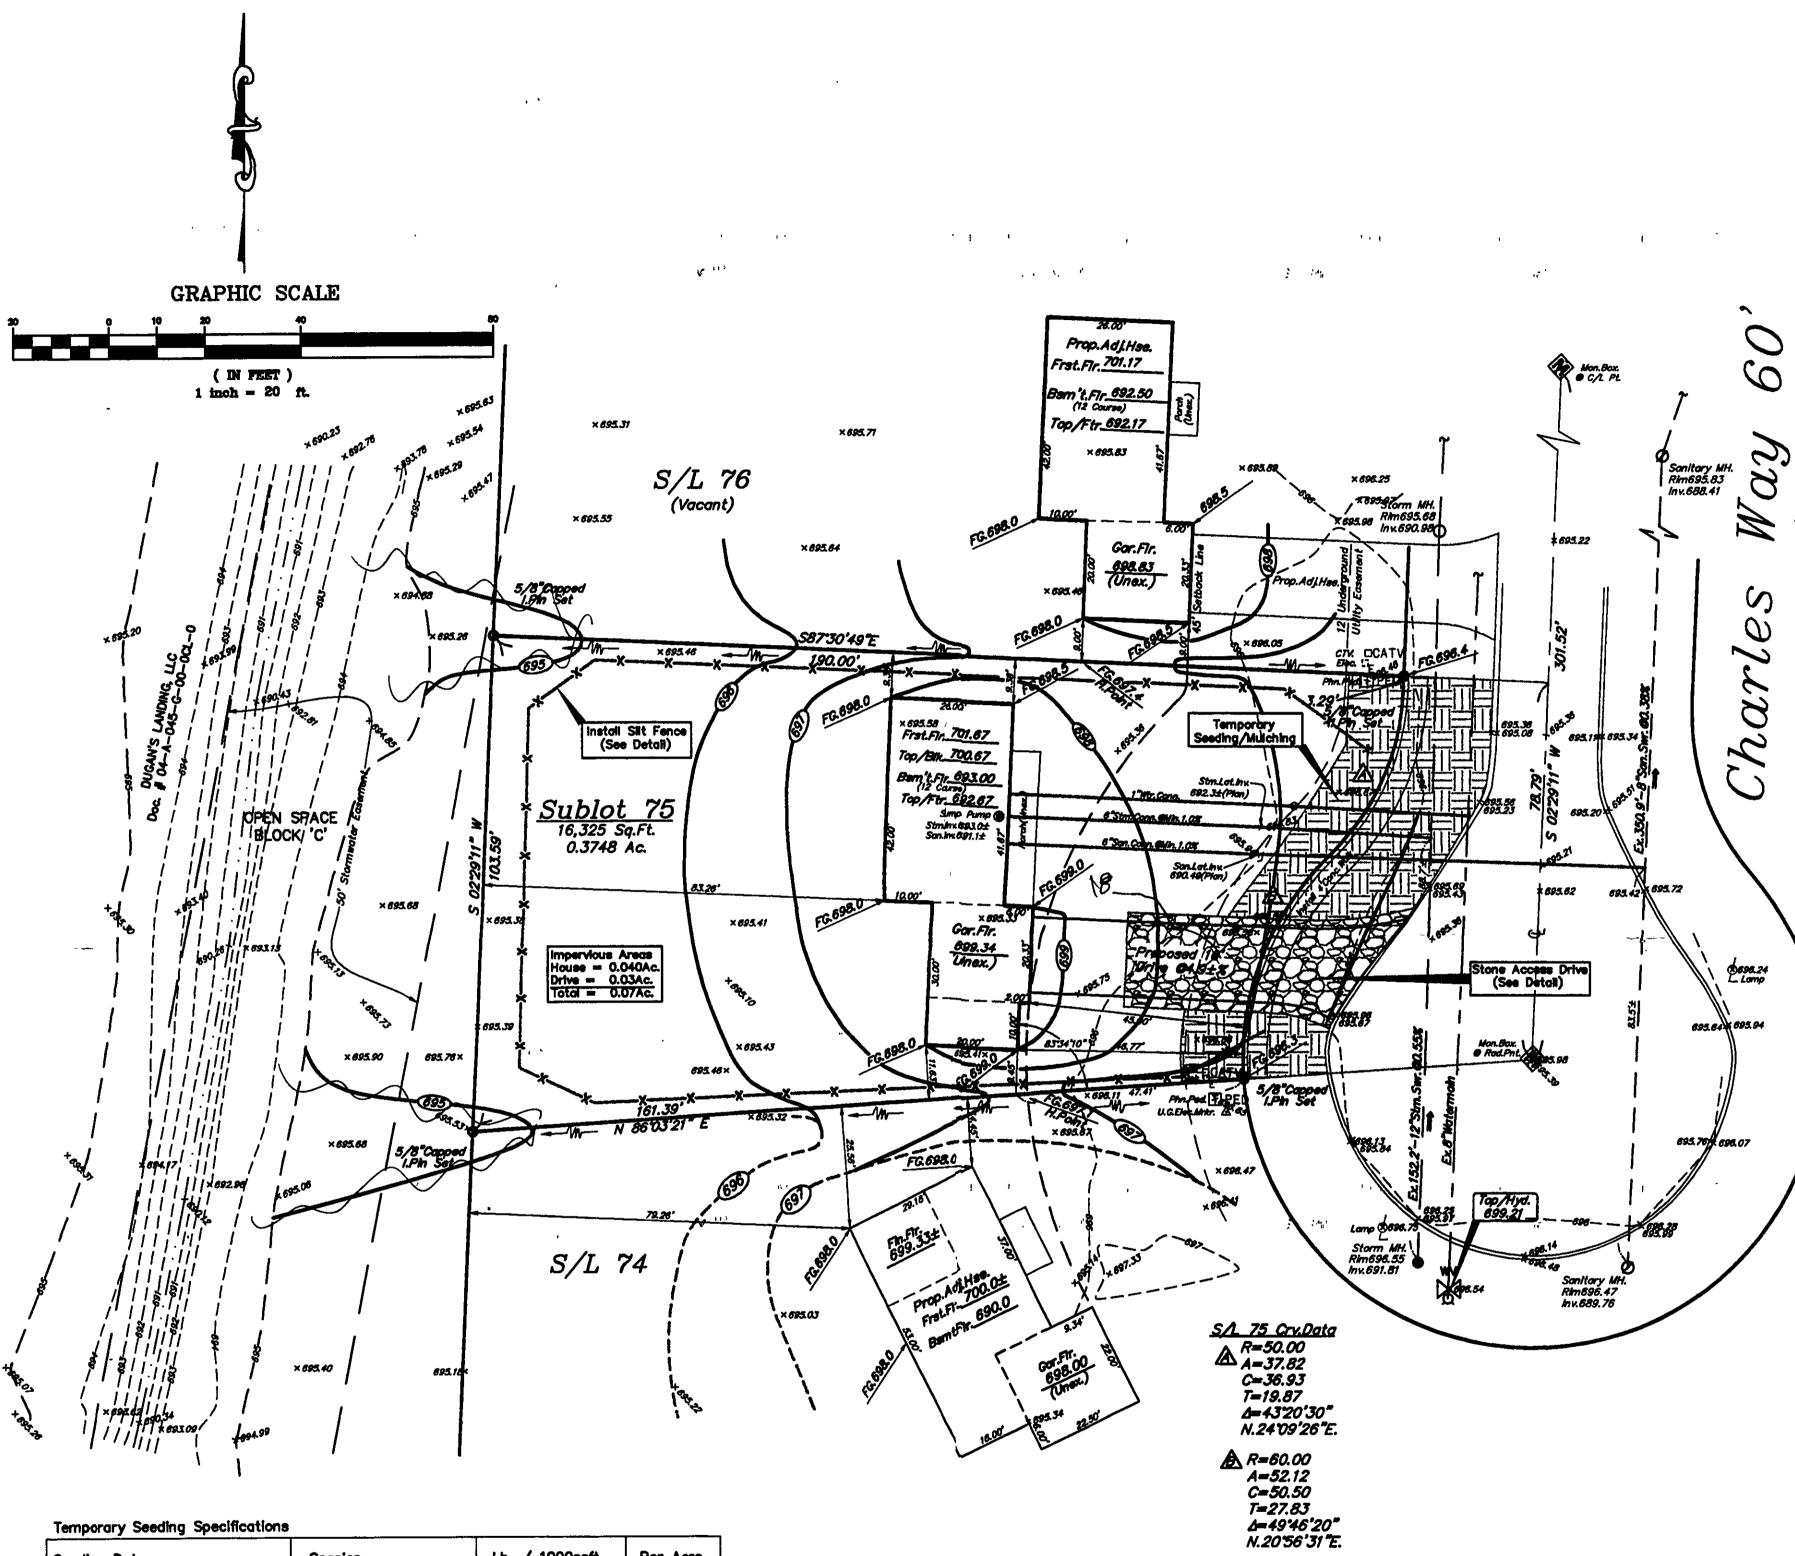

Lb. / 1000sqft Per Acre Species Seeding Dates March 1 to August 15 4 bushel Tail Fescue 40 lb. 40 lb. Annual Ryegrass Perennial Ryegrass
Tall Fescue 40 lb. 40 lb. Annual Ryegrass 40 lb. August 16 to November 1 Rye Tall Fescue 2 bushel 40 lb. Annual Ryegrass 40 lb. 40 lb. Tail Fescue 40 lb. Annual Ryegrass 40 lb. 40 lb. Perennial Ryegrass Tall Fescue 40 lb. Annual Ryegrass Use mulch only, sodding practices or dormant seeding

November 1 to Spring Seeding

Note: other approved seed species may be substituted

APPROVED MAS NOTED T AS SUBMITTED NOT APPROVED

SIGNATURE

-End Of Utility Connections Shown On This Plan Represent Existing Lateral Markers Located in The Field;

- Contractor To Verify Location & Depth Of Laterals; Contractor Shall Also Determine Depth Of Existing Sanitary Sewer Lateral To Verify That Basement Service For Sanitary Sewer Is Available:

-See Architect Plans For Complete House Dimensions: -Drive Apron To Be 6"Thick Concrete With 3 Foot Flores; -Sidewalk To Be ODOT-608. 4"Thick(6" Driveway) With 3"Gravel Or Sand Base.

Ingress—Egress
A stone access drive complete with under lying geo—textile fabric (20 feet wide and 50 feet long) for ingress and egress at the site shall be installed. This drive shall be the only entrance

Silt Fence
All silt fence shall be installed prior to any earthwork activities at the site in the locations shown on the site plan as well as along the front of any lot that slopes towards the street.

thirty (30) days shall be properly seeded and straw mulched within seven (7) days of completion of initial grading.

Temporary seeding and mulching of a thirty (30) foot strip of the entire front of the lot shall be maintained on the site once initial grading in secondary.

Stabilization of critical areas within fifty (50) feet of any stream or wetland shall be complete within two (2) days of the disturbance if the site is to remain inactive for longer than fourteen (14) days.

(10) feet of curb, at a width of thirty (30) feet of the entire length of the lot. Wood chips may also be used but must be spread at a minimum depth of four inches over the thirty-foot width and must be accompanied by a properly installed silt

Erosion and sediment controls shall be inspected every seven (7) days or within 24 hours of a 0.5" or greater rainfall event.

Necessary repairs shall be made at this time.

All erceion and sediment control specifications, applications, and timetables are based on the descriptions and standards of The Ohio Department of Natural Resources "Rainwater and Land Development Manual" and can be found in the Lake County Erosion and Sediment Control Rules as adopted December 21,

The specified erosion and sediment control standards are the general guidelines and shall not limit the right of the county to impose, at any time, additional, more stringent requirements. Nor shall the standards limit the right of the county to waive, in writing, individual requirements.

THE UNDERSIGNED, HEREBY CERTIFY THAT THIS TOPOGRAPHY, INDICATED BY 6", 1', OR 2' CONTOURS, AND ELEVATIONS SHOWN HEREON, REPRESENT AN ACTUAL FIELD SURVEY MADE BY ME ON THE 18th. DAY OF FEBRUARY, 2005, AND THAT THE ELEVATIONS WERE TAKEN AT APPROPRIATE INTERVALS AND THAT AS OF THAT DATE, THEY EXISTED AS INDICATED HEREON.

Washin K. Leeves Dustin R. Keeney, P.E.65515

Site & Grade Hea. 2-25-05 G.S.V.



POLARIS ENGINEERING & SURVEYING, INC. 34600 CHARDON ROAD — SUITE D WILLOUGHBY HILLS, OHIO 44094 (440) 944-4433 (440) 944-3722 (Fax) www.polaris-es.com


DESIGN CERTIFICATION

THIS PLAN WAS PREPARED BY ME, AND IS CORRECT TO THE BEST OF MY KNOWLEDGE AND BELIEF.

2/25/05 DATE

BENCHMARK:

B.M. = T.B.M Set On Top Of Hydrant Located In Front Of S/L 73 Elevation 699.21

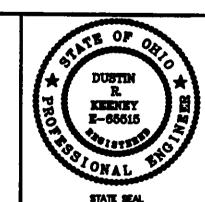

"AS-BUILT" CERTIFICATION

I HEREBY CERTIFY THAT THE CIRCLED INFORMATION IS EXISTING AS OBTAINED ON THE SITE _____ AND IS CORRECT TO THE BEST OF MY KNOWLEDGE AND BELIEF.

NAME

Prepared For:

R.L. Moore Builders

1360 Madison Ave.

Phn.(440)352-4996 Fax(440)352-2402

Painesville, Ohio 44077

DATE

SUBLOT 75 Dugan Farms Ph.5

Perry Village, Lake County, Ohio

05715 DATE: 2/22/05 SCALE: HOR. 1"=20" VERT.__ FILENAME: Sublot 75Site & Grading.dw TAB: S&G Plon

CONTRACT No.

Stormwater Management Plan Approved as shown and/or noted JAMES R. GILLS, P.E. County Drainage Engineer By <u>L.s.</u> Date <u>3/4/0</u>S

ROOF DRAINS SHALL DISCHARGE TO SPLASH BLOCKS.

CONNECT SUMP PUMP TO STORM CONNECTION